



Job Description: KC Route 11 Strategic Header Phase C




Maximo Work Order: 21514402  
 Project #: 803986

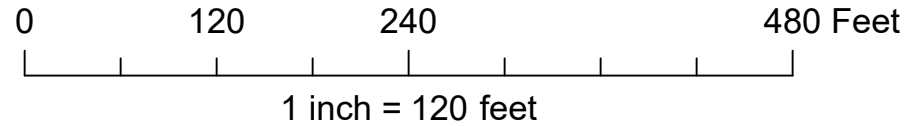

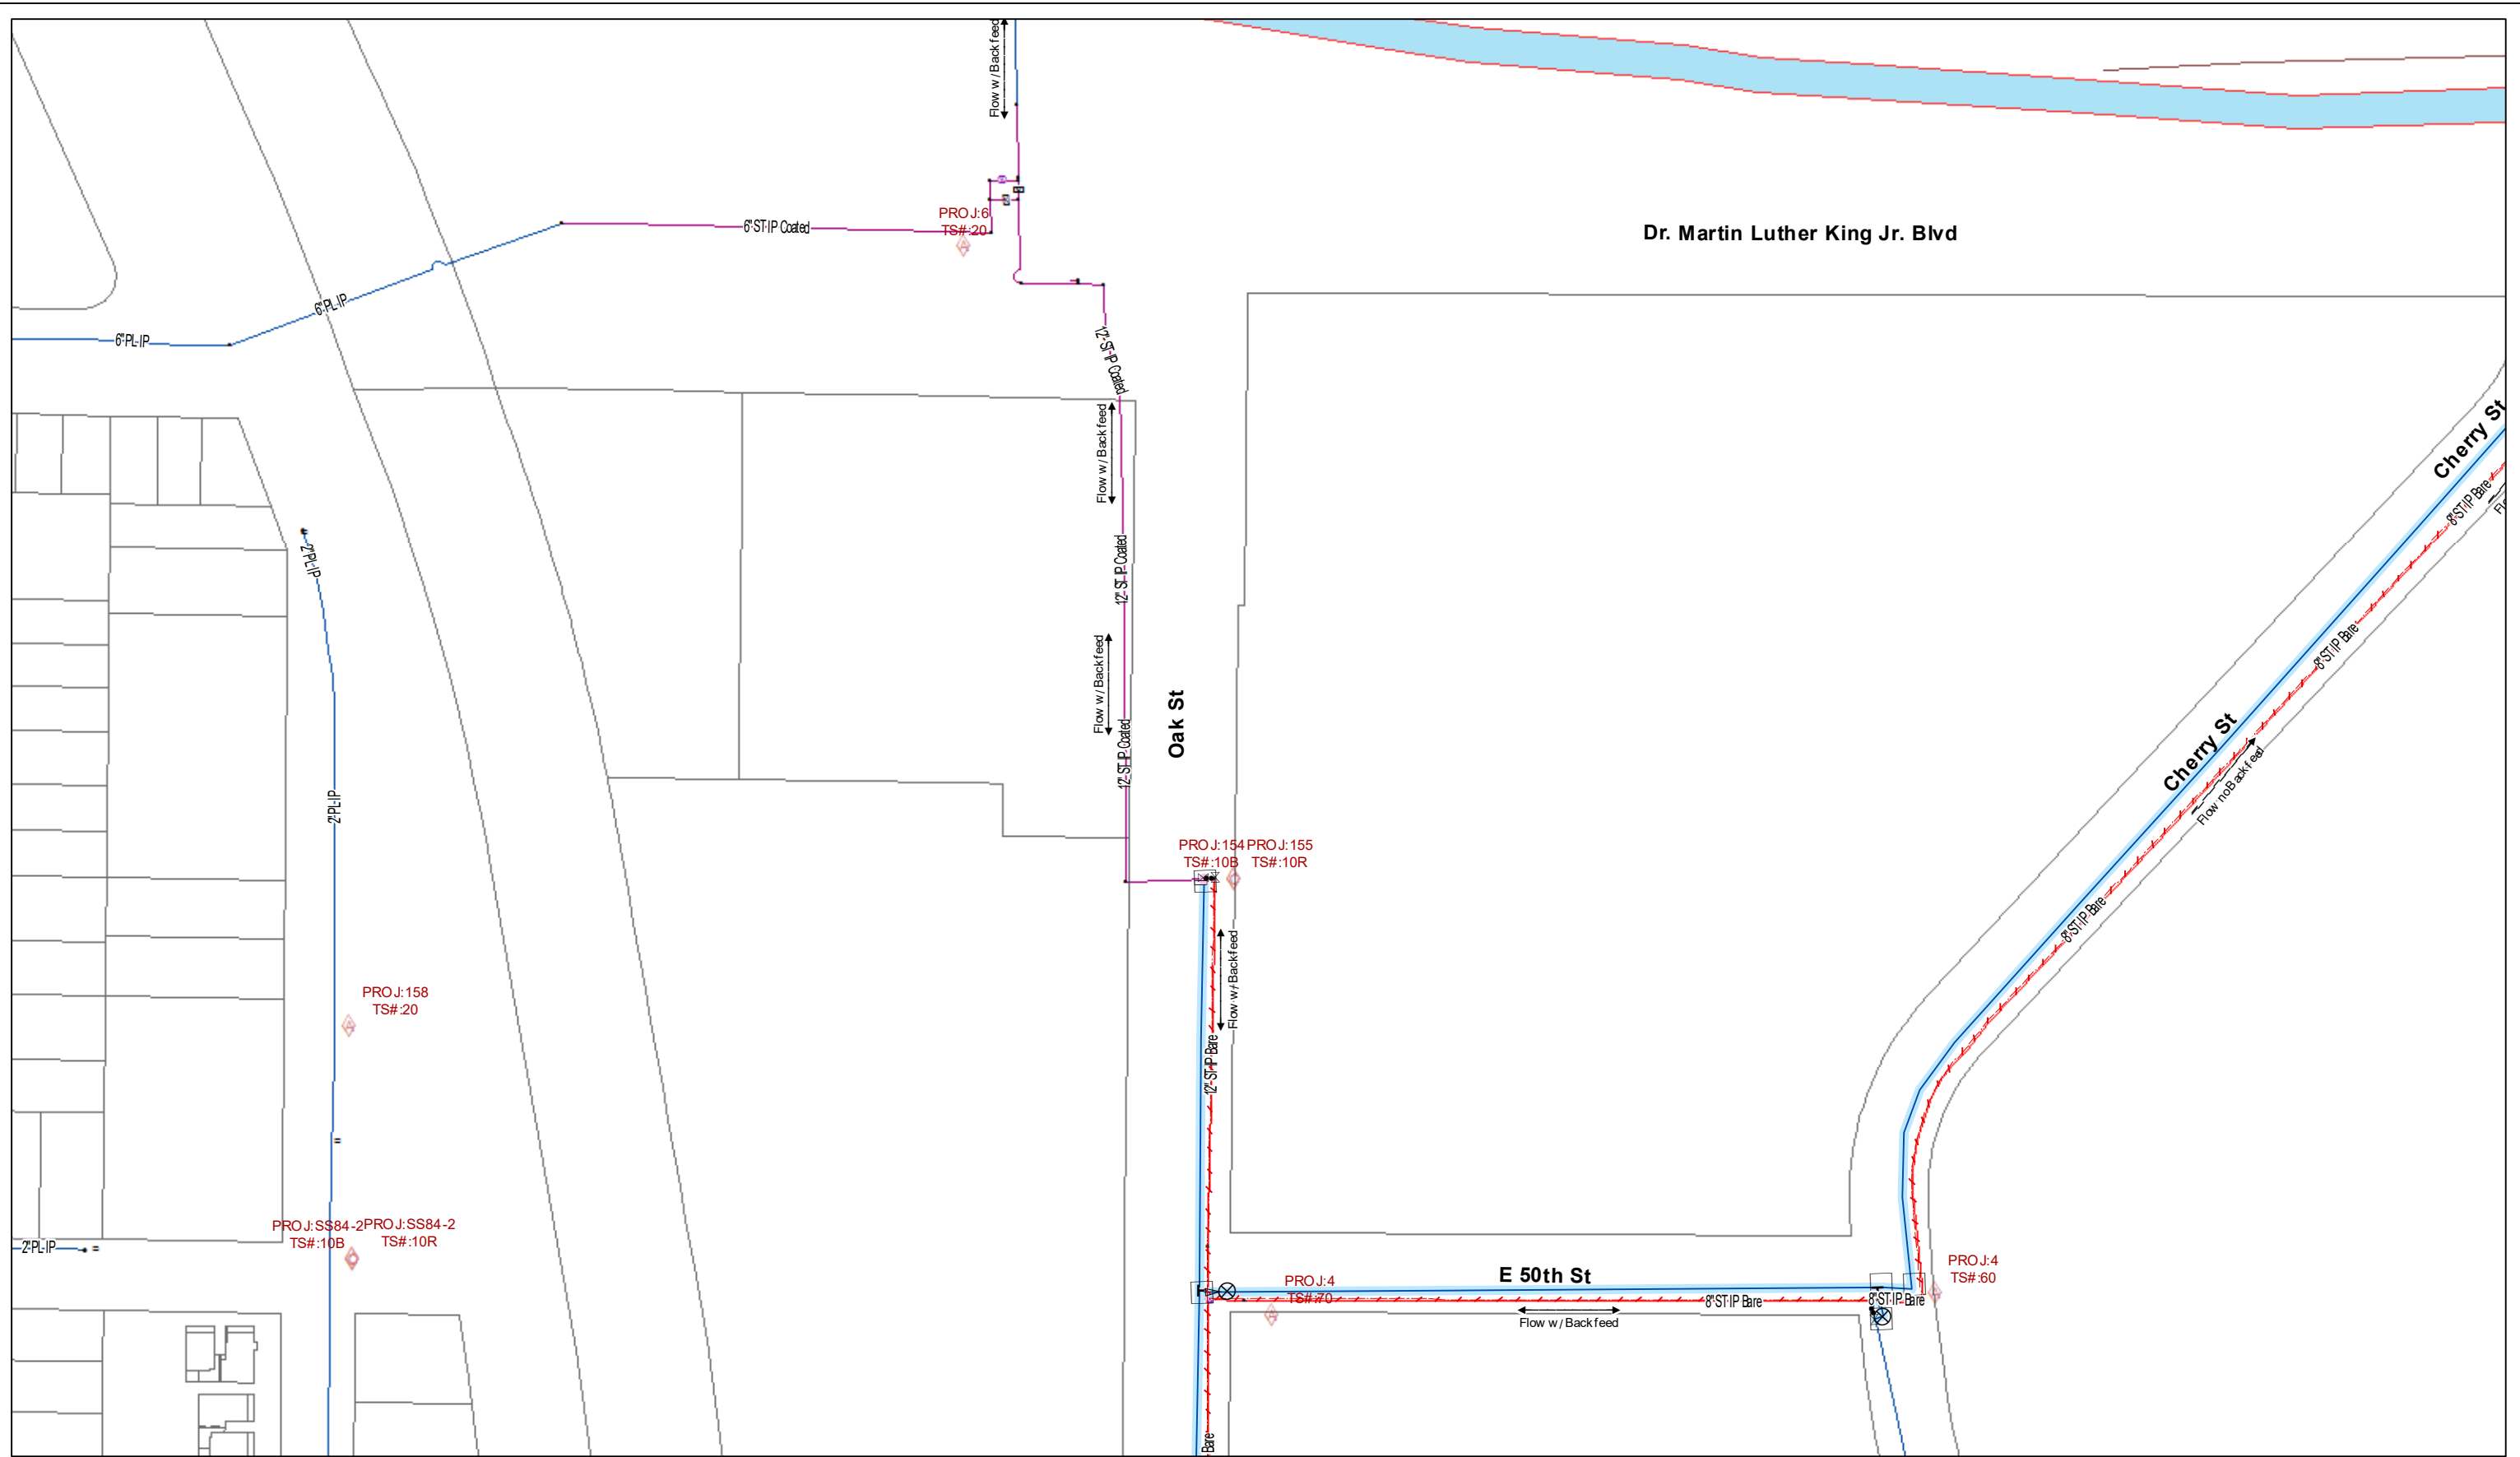


**Job Description: KC Route 11 Strategic Header Phase C**

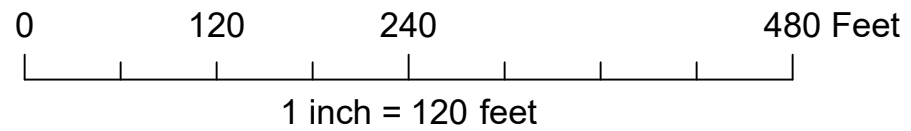


**Maximo Work Order: 21514402**  
**Project #: 803986**



**PAGE 3 OF 7**

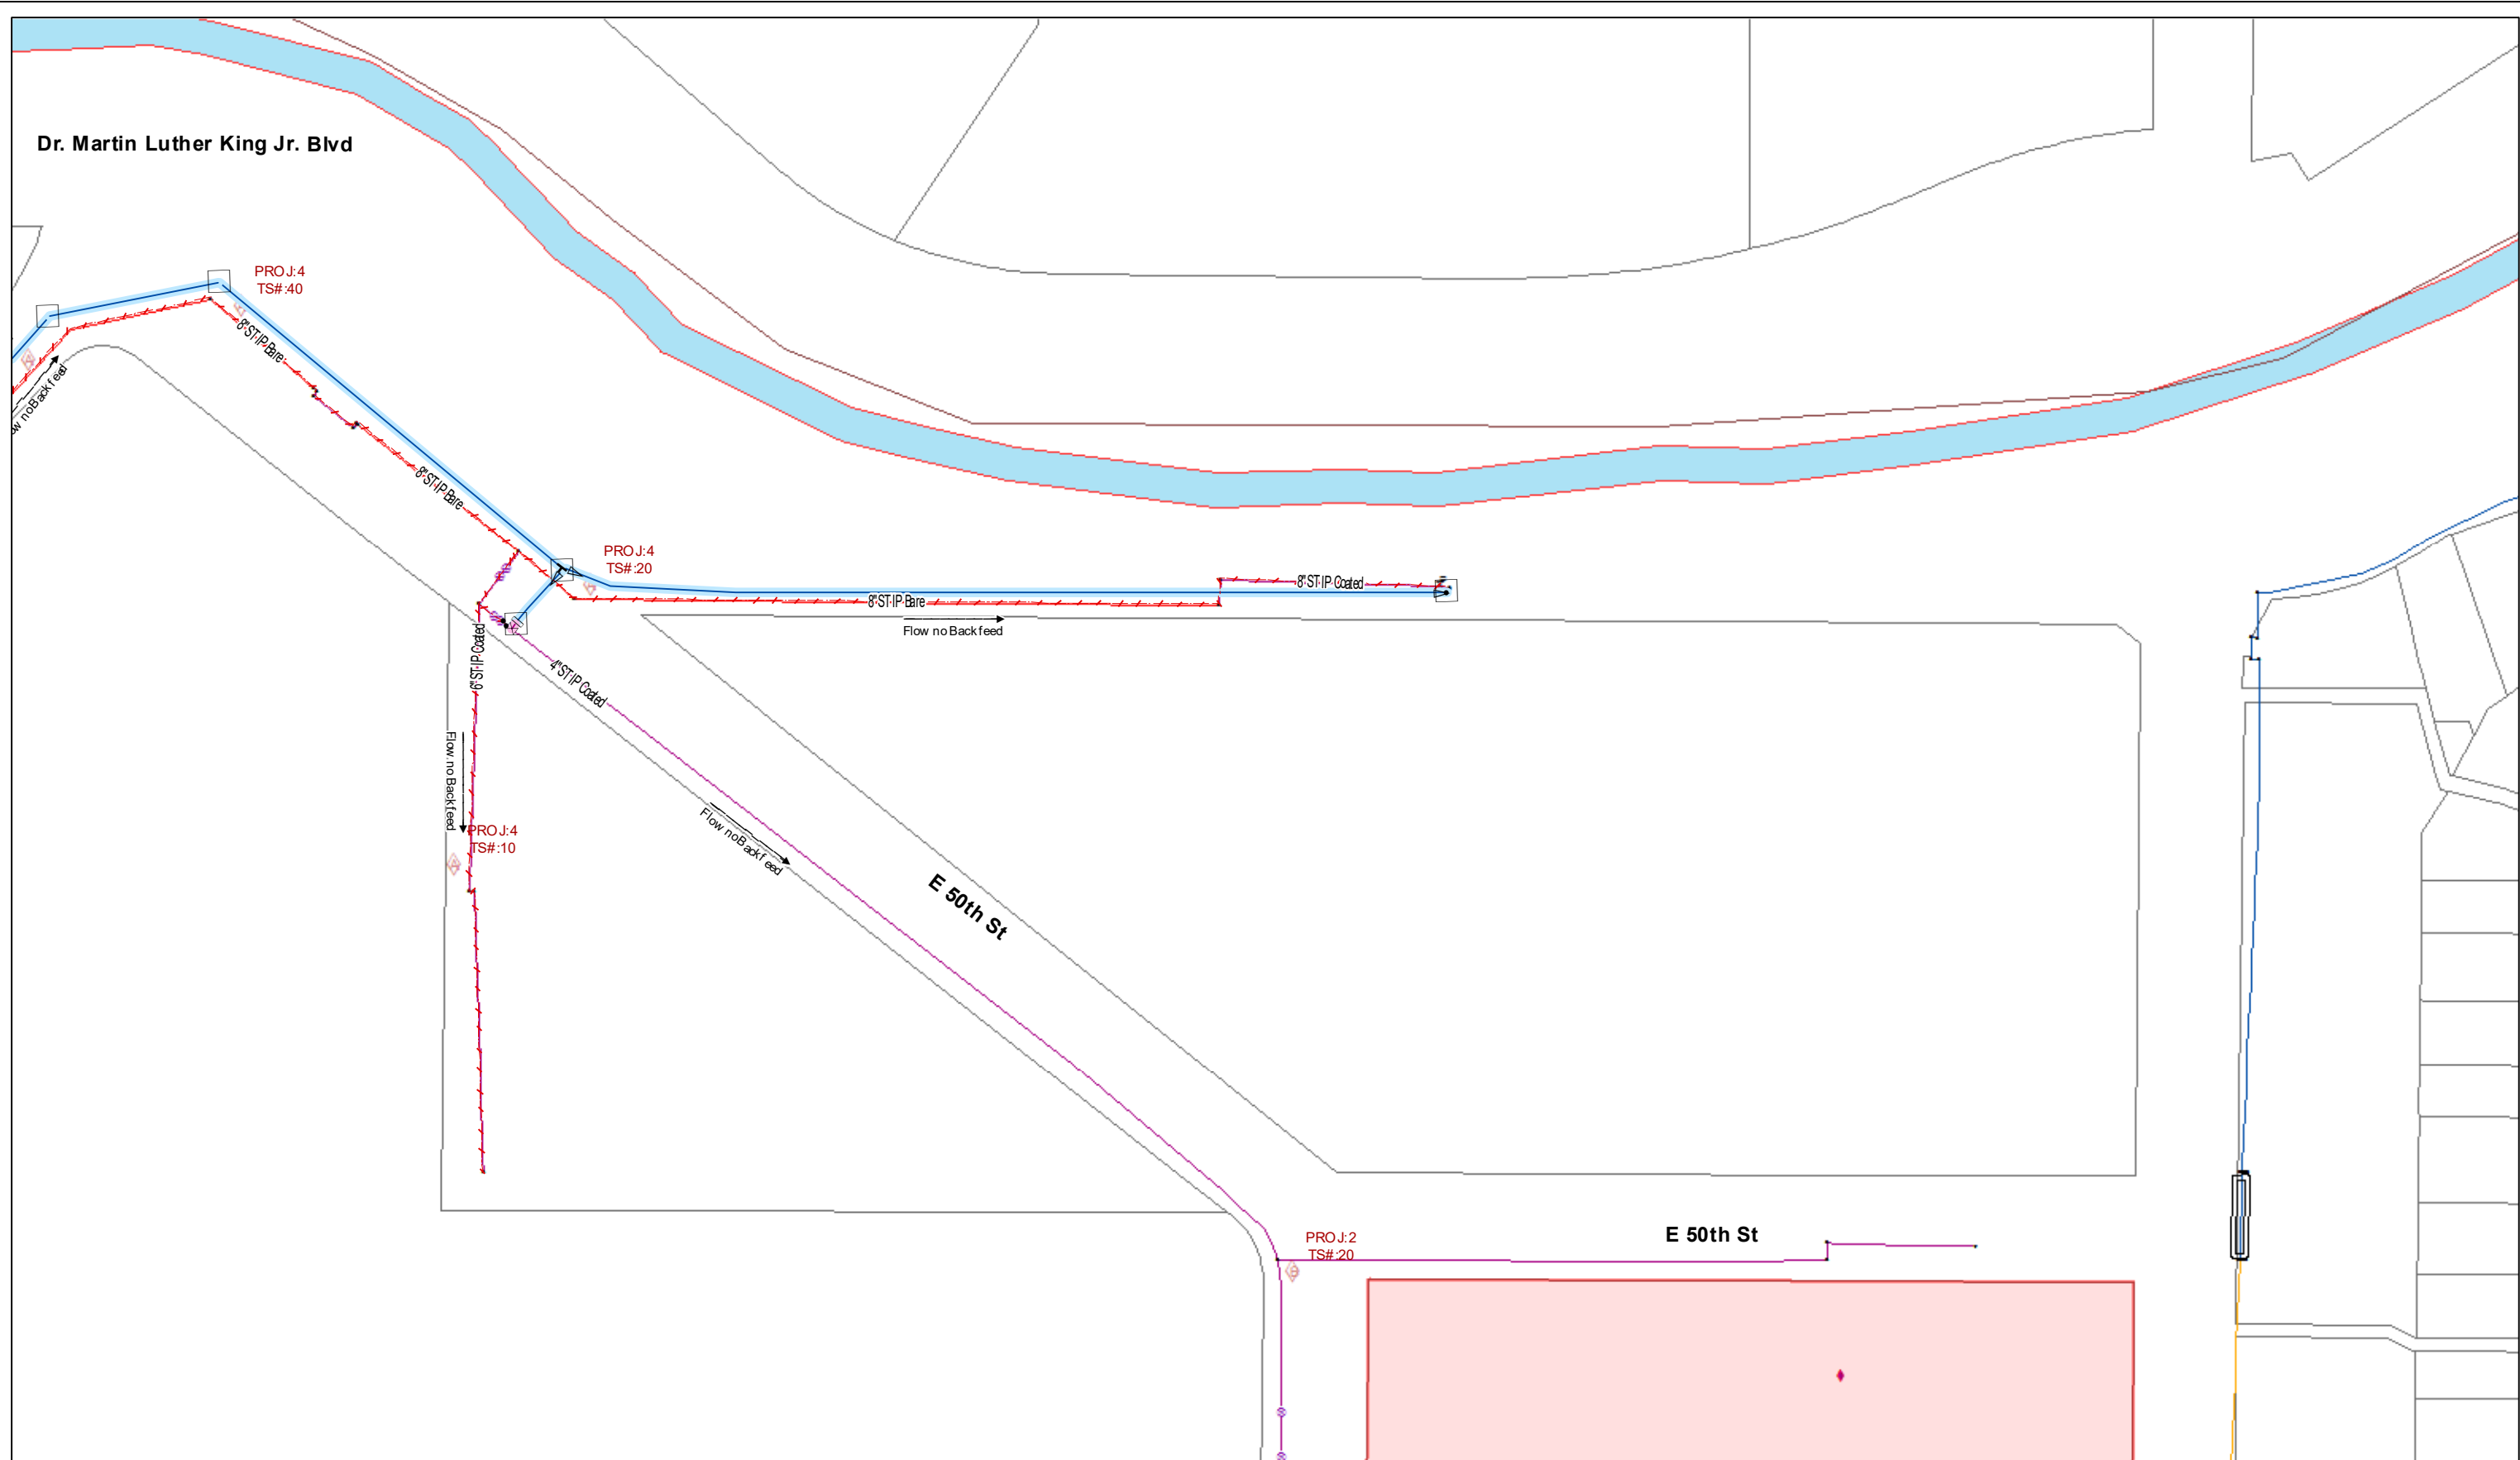


**Job Description: KC Route 11 Strategic Header Phase C**

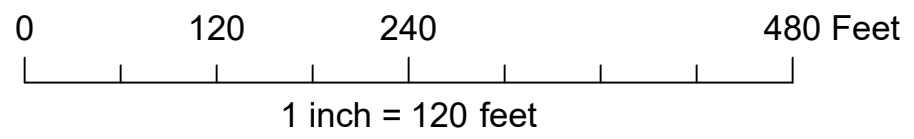


**Maximo Work Order: 21514402**  
**Project #: 803986**



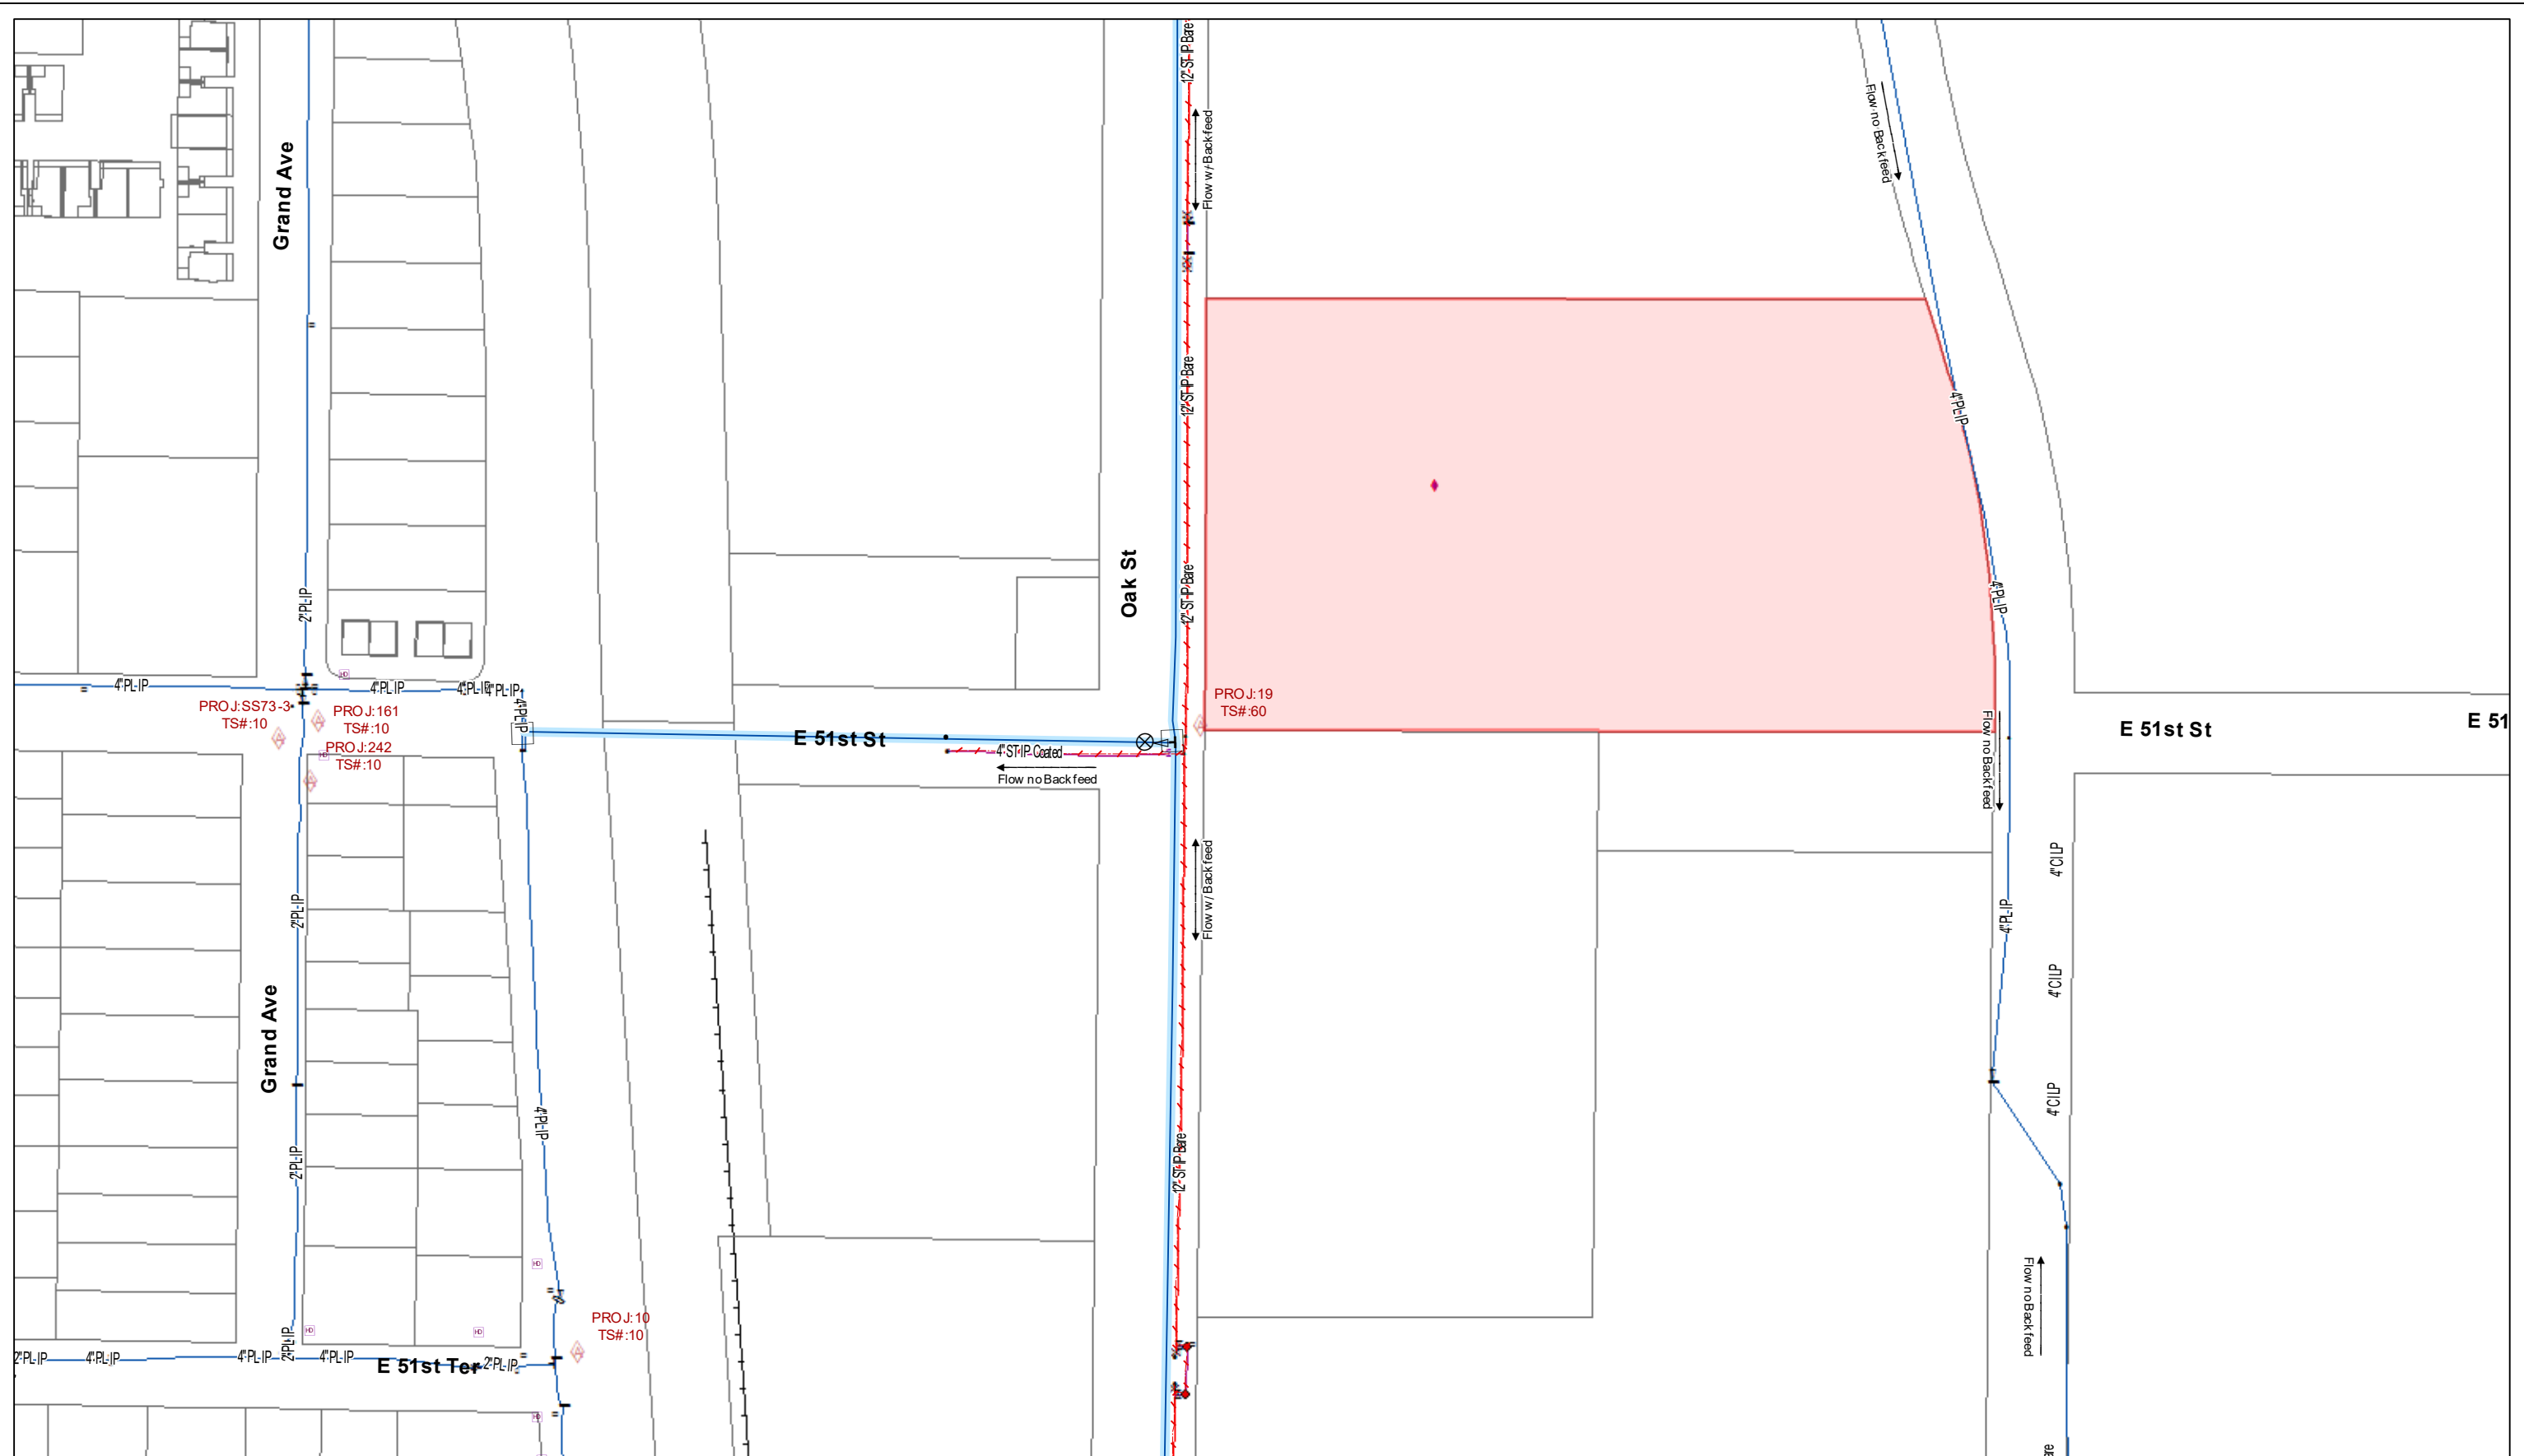


**Job Description: KC Route 11 Strategic Header Phase C**

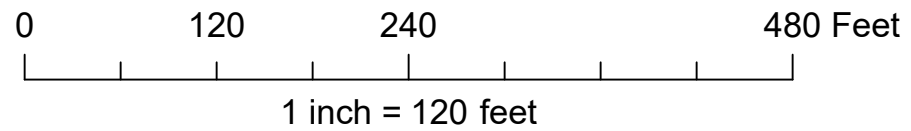


**Maximo Work Order: 21514402**  
**Project #: 803986**



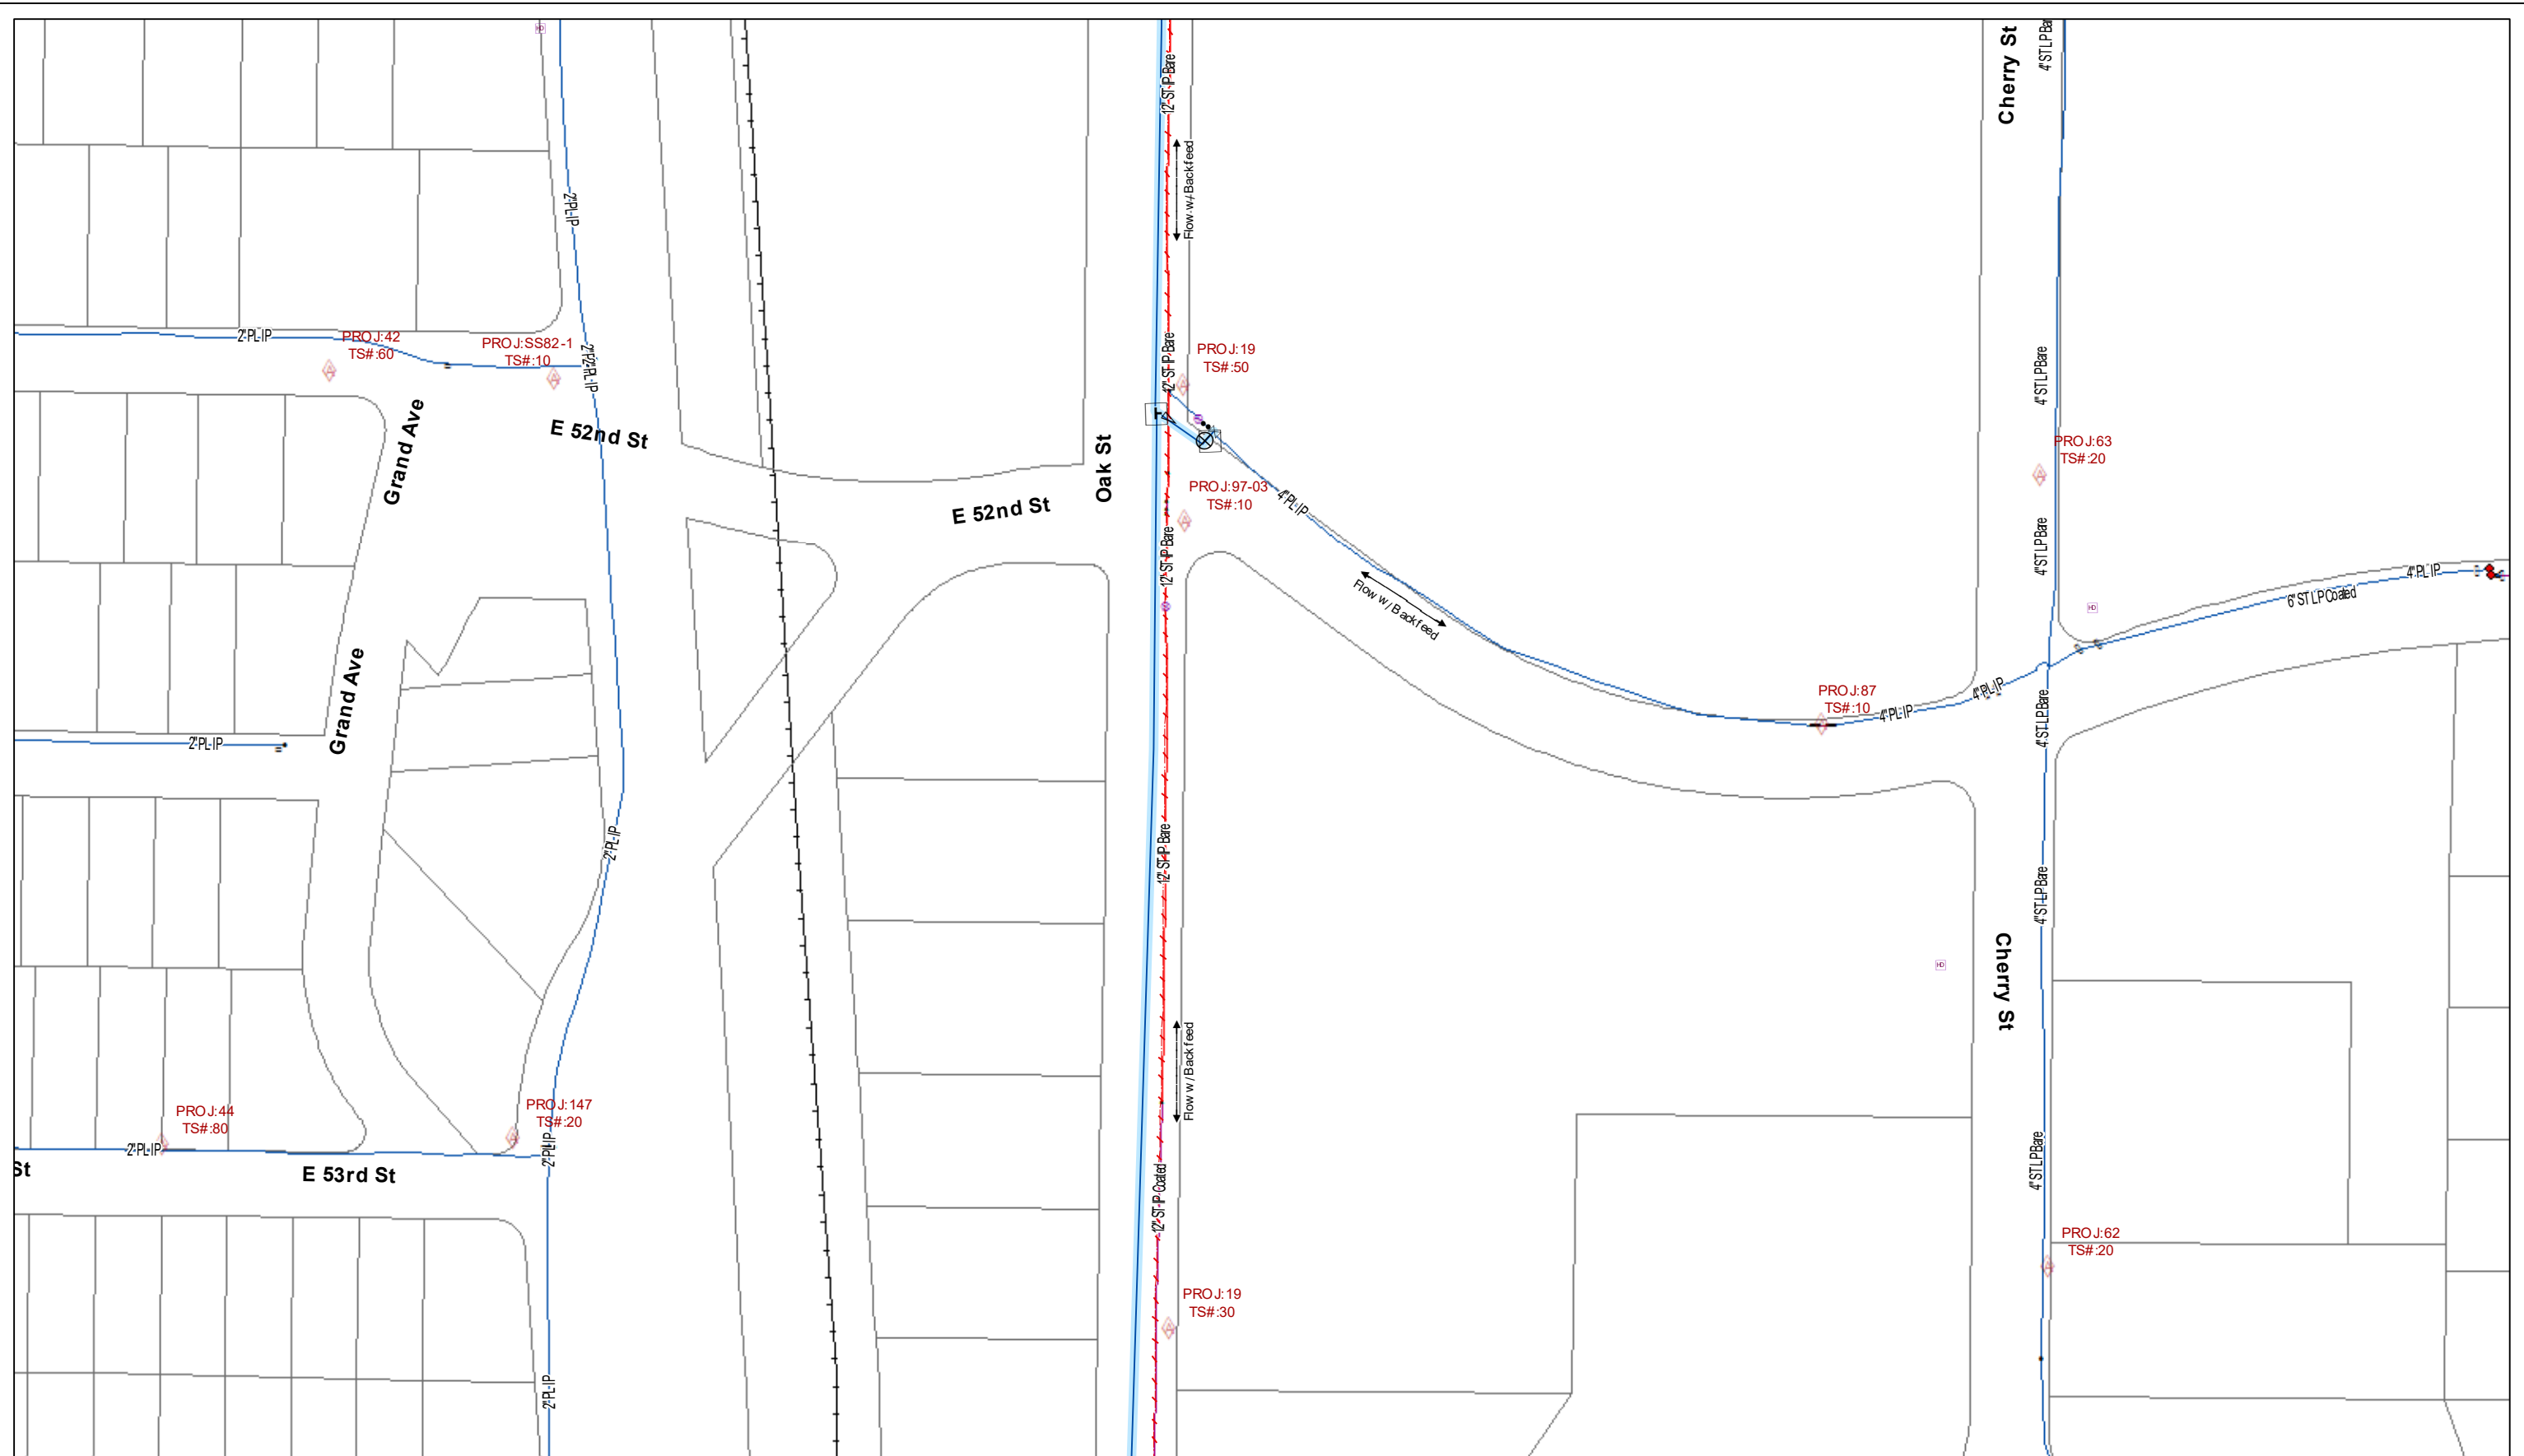


**Job Description: KC Route 11 Strategic Header Phase C**

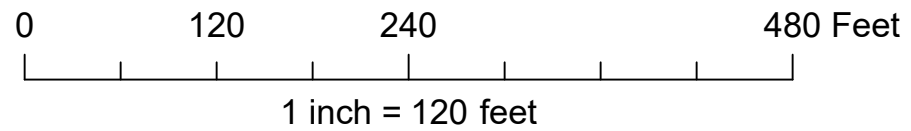


**Maximo Work Order: 21514402**  
**Project #: 803986**



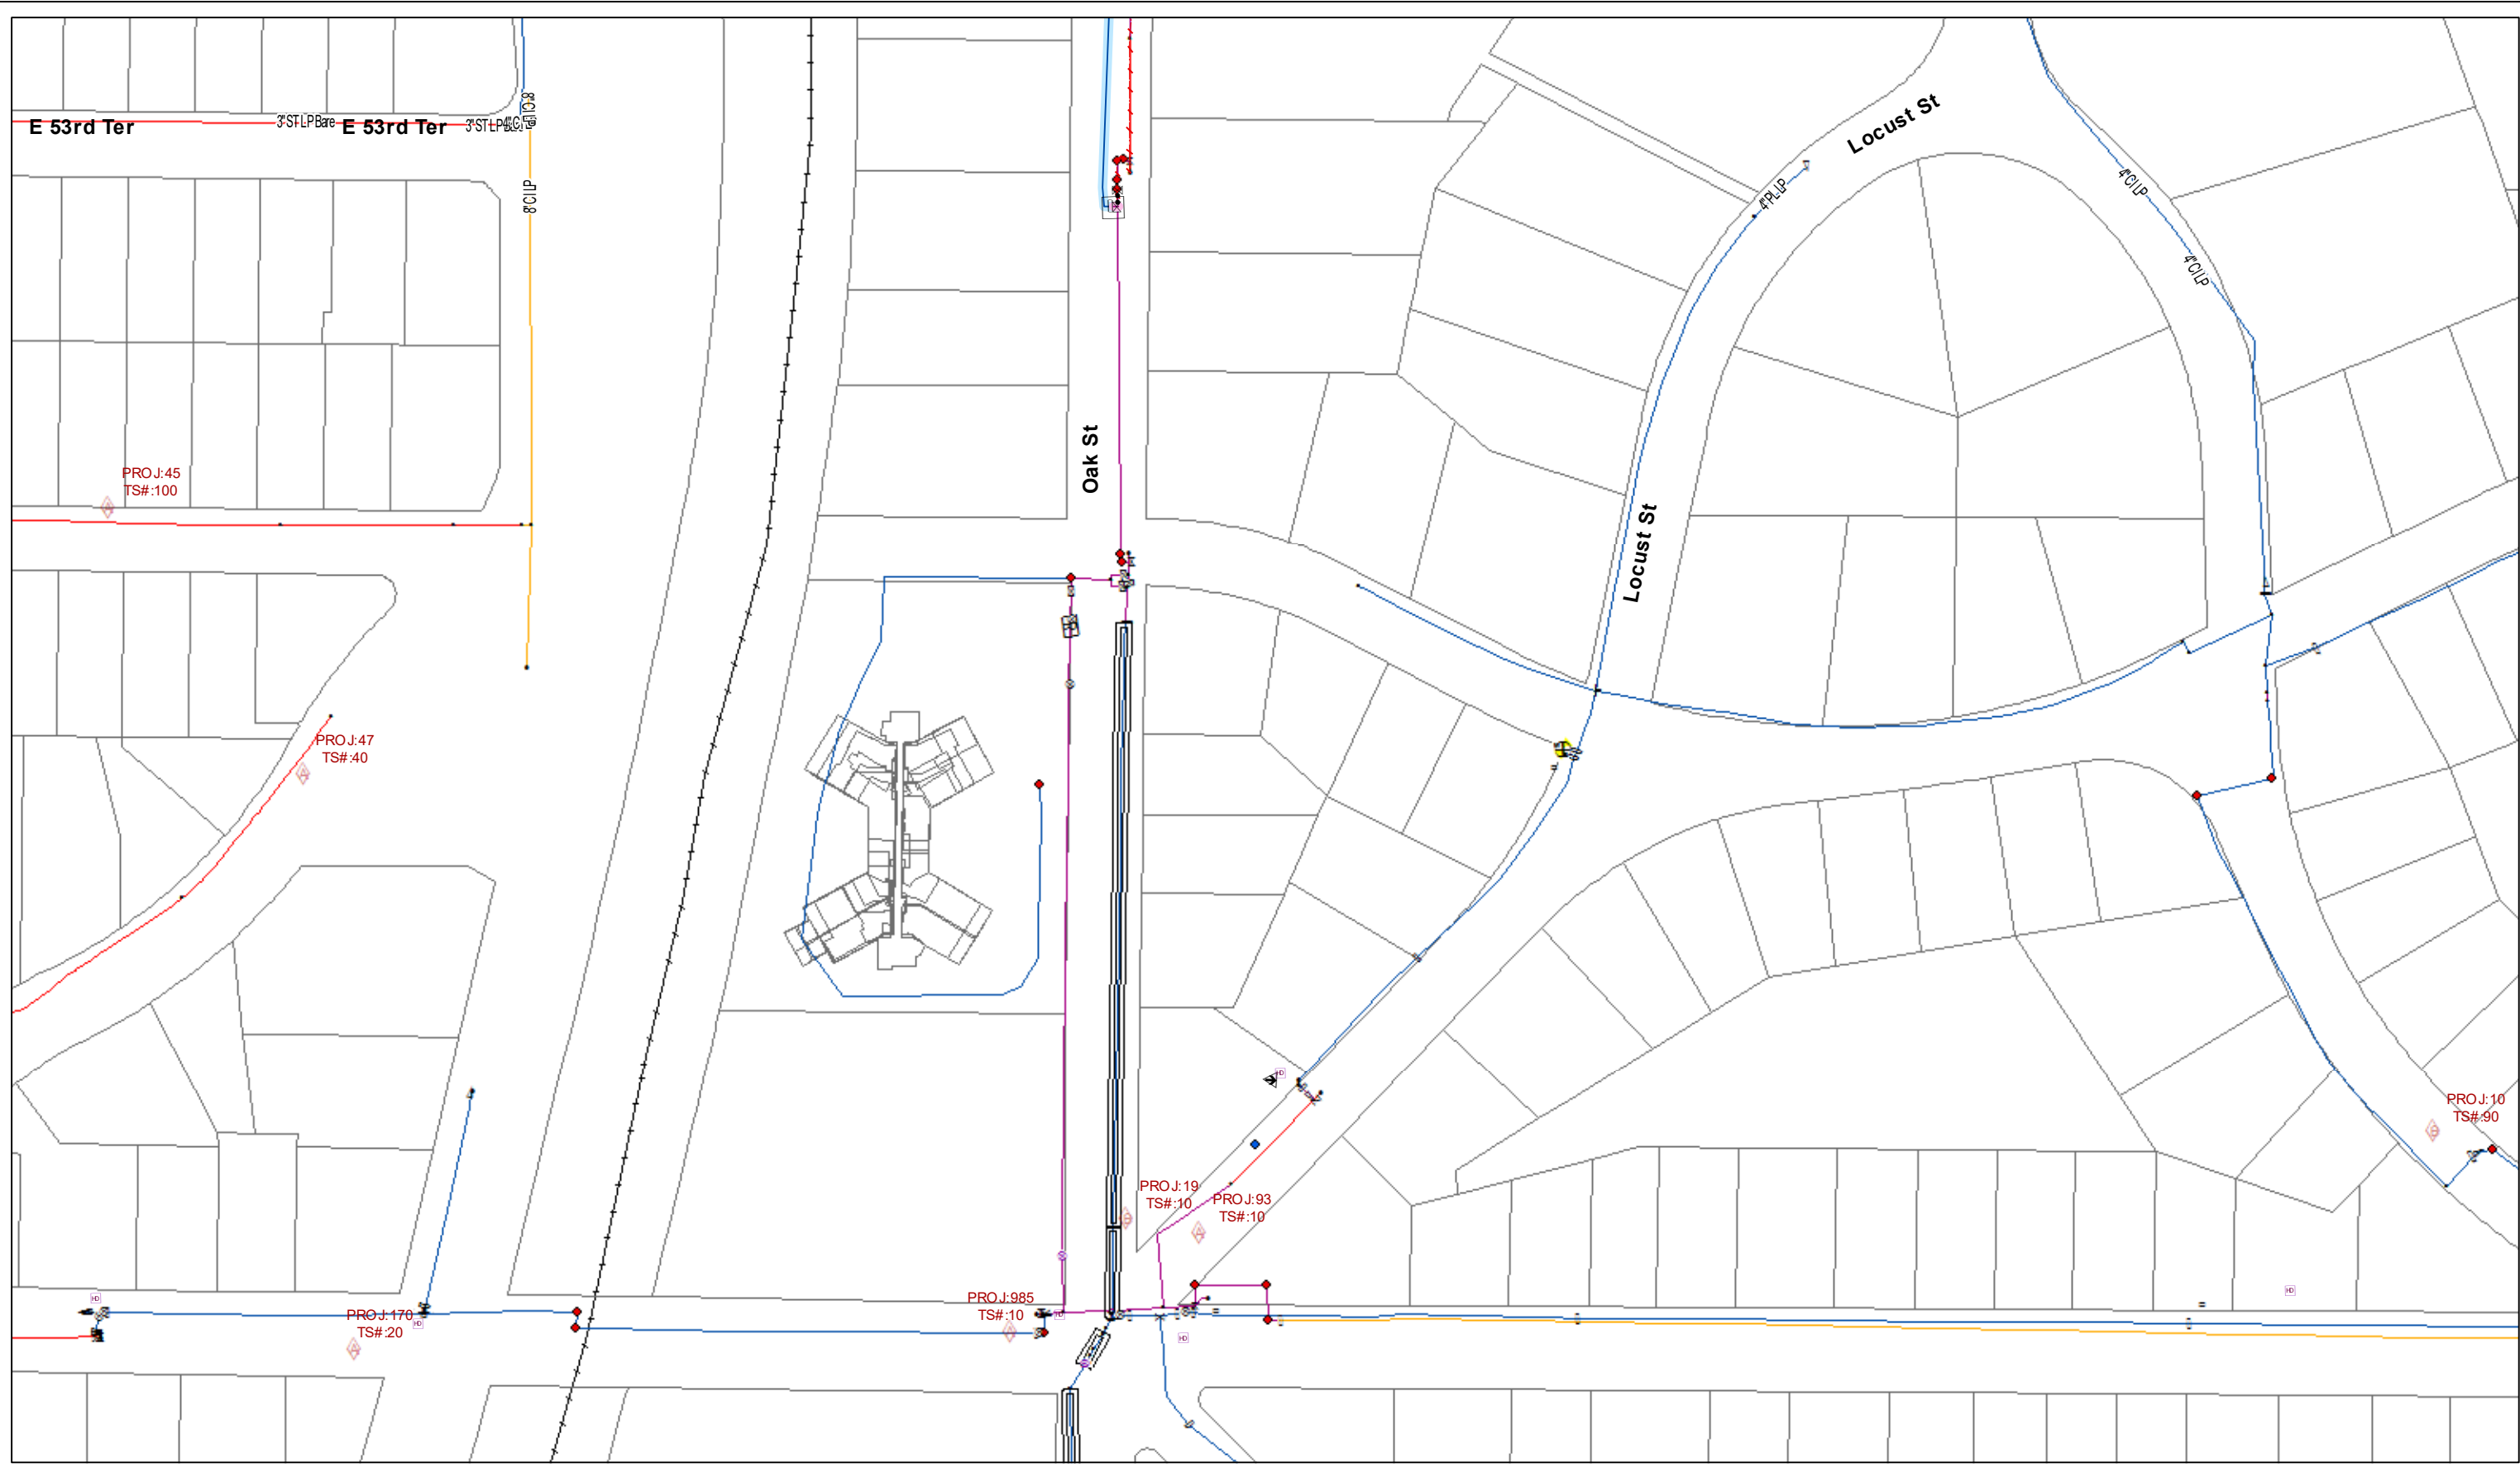

**Job Description: KC Route 11 Strategic Header Phase C**

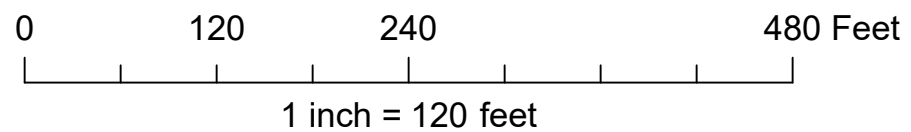

**Maximo Work Order: 21514402**  
**Project #: 803986**



**PAGE 7 OF 7**